

PROJECT NOTES

THIS SPECIFICATION IN CONJUNCTION WITH THESE DRAWINGS, AND SEPARATELY ISSUED INTERIOR DESIGN SPECIFICATIONS, PLANS, AND DETAILS, PROVIDES FOR THE LABOR, MATERIAL, EQUIPMENT, AND SUPERVISION BY THE CONTRACTOR FOR A COMPLETE LOCK-UP KEY JOB WITH THE ITEMS SPECIFICALLY NOTED FURNISHED BY OWNER OR ALLOWANCE. THE WORK SHALL BE EXECUTED IN A THOROUGH, SUBSTANTIAL AND NEAT MANNER. THE FLORIDA BUILDING CODE 5th EDITION (FBC 2014) IS THE APPLICABLE CODE FOR CONSTRUCTION. ALL BUILDING COMPONENTS SHALL COMPLY WITH SECTION 8-40 OF THE METRO-DADE CODE FOR PRODUCT COMPLIANCE AND APPROVAL.

A.I.A. DOCUMENT A-201 (LATEST EDITION) GENERAL CONDITION OF THE CONTRACT IS HEREBY MADE A PART OF THESE DRAWINGS AND SPECIFICATIONS.

CONTRACTOR SHALL ARRANGE FOR INSPECTION AND TESTS AS SPECIFIED OR REQUIRED BY THE BUILDING DEPARTMENT AND SHALL PAY ALL FEES AND COSTS FOR SAME. THE CONTRACTOR SHALL SECURE ALL BUILDING PERMITS AND UPON COMPLETION OF THE PROJECT (PRIOR TO FINAL PAYMENT) DELIVER TO THE OWNER A CERTIFICATE OF COMPLETION FROM TOWN OF GOLDEN BEACH BUILDING AND ZONING DEPARTMENT.

THE GENERAL CONTRACTOR AND MAJOR SUBCONTRACTORS SHALL VERIFY ALL DIMENSIONS, VISIT THE SITE, BE FAMILIAR WITH THE EXISTING CONDITIONS, AND BRING ANY DISCREPANCIES TO THE ARCHITECT'S ATTENTION PRIOR TO SUBMISSION OF CONSTRUCTION PROPOSAL AND ANY MOBILIZATION OR SITE WORK. DO NOT SCALE DRAWINGS.

REFERENCES ON PLANS REFER TO SECTIONS OF THE FLORIDA BUILDING CODE, 2014 EDITION. ALL BUILDING COMPONENTS SHALL COMPLY WITH SECTION 8-C OF THE METRO-DADE CODE FOR PRODUCT COMPLIANCE AND APPROVAL.

ALL COLORS AND FINISHES SHALL BE AS SPECIFIED AND/OR AS SELECTED BY THE OWNER OR ARCHITECT, AND WHERE POSSIBLE MATERIALS AND FINISHES SHALL MATCH EXISTING.

ALL AREAS DAMAGED BY DEMOLITION SHALL BE RETURNED TO THEIR ORIGINAL OR RENOVATED CONDITION AS INDICATED ON THE PLANS.

ALL INTERIOR PARTITIONS SEPARATING HABITABLE SPACES WILL RECEIVE MINIMUM 3.5" SOUND ATTENUATION RATING.

APPROVED STORM PANELS SHALL BE PROVIDED FOR ALL NEW WINDOWS AND DOORS APPROVED FOR INSTALLATION BUT NOT ACCEPTED BY DADE COUNTY FOR IMPACT REQUIREMENTS.

WOOD: ROUGH FRAMING MATERIAL, SOUTHERN YELLOW PINE. IN CONTACT WITH MASONRY OR IN DAMP LOCATIONS, PRESURE TREAT. FINISH OR EXPOSED SHALL BE CLEAR FINLARCH OR SPECIES FOR PAINTED (OPAQUE) MILLWORK AS THE OWNER SELECTS.

WOOD CONNECTORS: ALL BOLTS, CLIPS, STRAPS, MISC. ANGLES, LAGS, ETC., WILL BE HOT DIP GALVANIZED.

ALL ELECTRICAL DEVICES, SWITCH PLATES, OUTLETS, ETC., WILL BE AS THE OWNER SELECTS, OR MATCH EXISTING.

WALKS AND/OR DRIVE AREAS SHALL BE PROTECTED DURING CONSTRUCTION TO PREVENT DAMAGE TO EXISTING PAVED OR CONCRETE SURFACES.

ALL TRASH AND DEBRIS GENERATED BY THE CONTRACTOR FOR SCOPE OF WORK DESCRIBED IN THIS DOCUMENT SHALL BE REMOVED AT REGULAR INTERVALS DURING THE COURSE OF CONSTRUCTION. A TRASH DUMPSTER WILL BE PROVIDED ON SITE BY THE GC.

CONTRACTOR SHALL MAINTAIN CLEAN AND SAFE ACCESS TO PREMISES BY OWNER AT ALL TIMES. SECURITY SYSTEM FULL TIME 100% COVERAGE DURING CONSTRUCTION.

PAINTING: ALL PAINT SHALL BE FIRST LINE SHERWIN WILLIAMS, BENJAMIN MOORE OR PRATT & LAMBERT OR OWNER APPROVED EQUAL. COLORS AS SELECTED BY THE OWNER. INTERIOR SPACES TO BE PAINTED ARE LIMITED TO NEW CONSTRUCTION AREAS AND THOSE AFFECTED BY CONSTRUCTION.

EXTERIOR STUCCO 2 COATS ACRYLIC LATEX.

INTERIOR WALLS - LOW LUSTER LATEX 2 COATS.

WOODWORK EXTERIOR - OIL BASE ENAMEL 2 COATS OR CABOTS STAIN.

WOODWORK INTERIOR - SANDING SEALER 2 COATS OIL BASE ENAMEL.

SANDING SEALER 2 COATS SATIN CLEAR FINISH WITH BLEACH TREATMENT OR STAIN AS OWNER SELECTS.

INTENT IS TO PROVIDE SATISFACTORY FINISH TO ALL PORTIONS OF THE BUILDING AFFECTED BY THIS CONSTRUCTION. ALL EXISTING SURFACES SHALL BE CLEANED AND THOROUGHLY PREPARED TO RECEIVE PAINTER'S FINISH. IF SPECIFIED FINISH DOES NOT MEET ACCEPTABLE COVERAGE, ADDITIONAL COATS WILL BE PROVIDED TO GIVE SATISFACTORY COVERAGE.

ALL CERAMIC TILE SURFACES ON EXTERIOR BALCONIES SHALL BE PLACED ON THIN SET OR GROUT BED (WHICHEVER IS APPLICABLE). ALL ELEVATED CONCRETE SLABS RECEIVING TILE SHALL BE PREPARED WITH "DEK-O-TEX" FLUID APPLIED WATER-PROOFING TREATMENT OR EQUAL PRIOR TO APPLICATION OF SETTING BED MATERIAL.

CONCRETE: OWNER'S GC IS RESPONSIBLE TO FLASH, PATCH, SCRAPE, OR GRIND THE NEW OR EXISTING CONCRETE SLAB AND TO PROVIDE A SMOOTH SURFACE, FREE FROM HOLES, BUMPS, OR CRACKS PRIOR TO THE APPLICATION OF ANY FINISH FLOORING.

STRUCTURAL METALS: THE DESIGN, FABRICATION, AND INSTALLATION OF ALL MISC. METAL, LINTELS, SUPPORTS, AND FRAMING SHALL BE THE SOLE RESPONSIBILITY OF THE OWNER'S GENERAL CONTRACTOR. SHOP DRAWINGS OF SUCH MISC. METAL WORK SHALL BE SUPPLIED TO THE OWNER FOR APPROVAL.

METAL STUD SYSTEM: ALL INTERIOR PARTITIONS SHALL BE CONSTRUCTED AS FOLLOWS: FOR PARTITIONS UP TO AND INCLUDING 12'-0" IN HEIGHT, USE 3-5/8" 20 GA. STUDS AT 16" O.C. FOR PARTITIONS ABOVE 12'-0" IN HEIGHT, USE 5-1/2" 18 GA. STUDS AT 16" O.C. ALL PARTITIONS TO HAVE 5/8" FIRE CODED GYPSUM BOARD.

BUILDING DEPARTMENT NOTES

ZONING SUMMARY

TOWN OF GOLDEN BEACH

ZONING DISTRICT: SINGLE FAMILY RESIDENCE - ZONE I

NET LAND AREA: 25,337 SF.

	REQUIRED	EXISTING	PROPOSED
HEIGHT (TO ROOF RIDGE)	27'-6" MAX.	29'-0"	N/A
FRONTAGE	75' FT. MIN.	75' FT.	75' FT.
LIVING AREA	3,000 SF		
1ST LEVEL		4,187 SF	4,187 SF
2ND LEVEL		2,130 SF	2,179 SF
A/C STORAGE (NON-HABITABLE BASEMENT)		2,121 SF	2,121 SF
GARAGE		491 SF	491 SF
FRONT COVERED PORCH		171 SF	171 SF
REAR COVERED TERRACE		308 SF	308 SF
COVERED BALCONIES		178 SF	178 SF
CABANA		148 SF	148 SF

LOT COVERAGE	5,284 SF.	5,284 SF.
POOL DECK	22,000 SF.	22,000 SF.
DRIVEWAY	2,765 SF.	2,765 SF.
PAVED WALKWAYS	1,284 SF.	1,284 SF.
LANDSCAPE (PERVIOUS 35% MIN. REQ. = 8,868 SF.)	11,021 SF.	11,021 SF.

BUILDING SETBACKS	REQUIRED	EXISTING	PROPOSED
FRONT	6'-0"	6'-6"	6'-6"
REAR	N/A		
SIDE	10'-0"	10'-11/8"-9"	10'-11/8"-9"
SIDE STREET	N/A		
ACCESSIONARY GARAGE			
FRONT	2'-0"	2'-0"	2'-0"
REAR	N/A		
SIDE	10'-0"	10'-0"	10'-0"

ALL EQUIPMENT SHALL BE INSTALLED 12" ABOVE THE BASE FLOOD ELEVATION OR ABOVE DESIGN FLOOD ELEVATION WHICH EVER IS HIGHER. VERIFY WITH INDIVIDUAL MUNICIPALITY REQUIREMENTS.

NOTICE: IN ADDITION TO THE REQUIREMENTS OF THIS PERMIT, THERE MAY BE ADDITIONAL RESTRICTIONS APPLICABLE TO THIS PROPERTY THAT MAY BE FOUND IN THE PUBLIC RECORDS OF DADE COUNTY, SECTION 553.75 (10), FLORIDA STATUTES, EFFECTIVE 1/10/01.

BUILDING INFORMATION

1. BUILDING INFORMATION

a. OCCUPANCY TYPE (FBC - CHAP. 3)	GROUP "R3"
b. CONSTRUCTION TYPE (FBC CHAP. 3)	TYPE III-B
c. NO. OF STORIES	3 STORIES
d. FIRE SUPPRESSION	N/A
e. FIRE ALARM	N/A
f. TOTAL BLDG. AREA	5,284 SF. TOTAL

2. CLASSIFICATION OF WORK

a. ALTERATION LEVEL 2 (FBC-EXISTING BLDG.)
b. MODIFICATION (NFPA-101, CHAP. 43)

3. MINIMUM FIRE RESISTANCE, FBC-R 302

a. INTERIOR WALL AND CEILING - FLAME SPREAD INDEX NOT GREATER THAN 200 -AND- SMOKE DEVELOPMENT INDEX NOT GREATER THAN 450
b. CONCEALED AND EXPOSED INSULATION - FLAME SPREAD INDEX OF 75 MAX. -AND- SMOKE DEVELOPED INDEX OF 450 MAX.

GENERAL NOTES

- BATHROOM FLOORS AND BASE TO BE OF IMPERVIOUS MATERIAL AS PER FBC 1102 AND 2509.1.
- IN AN OUTSIDE WINDOW OR DOOR OPERABLE FROM THE INSIDE, THE MODE OF OPERATION SHALL NOT REQUIRE THE USE OF A KEY, TOOL, SPECIAL KNOWLEDGE OR EFFORT. SUCH CLEAR OPENING SHALL BE NOT LESS THAN 20" IN WIDTH AND 24" IN HEIGHT. 57 SQ. FT. IN AREA AND SHALL ALSO MEET THE PROVISIONS OF SECT. 1309. THE BOTTOM OF THE OPENING SHALL NOT BE MORE THAN 44" ABOVE THE FINISHED FLOOR AND NO PART OF THE OPERATING MECHANISM SHALL BE PLACED HIGHER THAN 54" ABOVE FINISHED FLOOR.
- NUMBERS OF ADDRESS SHALL BE PLACED VISIBLE AND LEGIBLE FROM THE STREET FRONTING THE PROPERTY AND SHALL BE 4 INCHES MIN. IN HEIGHT.
- TOILET ROOMS SHALL COMPLY WITH FBC-1307.
- REFER TO FOUNDATION PLAN FOR CONCRETE FILLED BLOCK CELL LOCATION, SIZE AND REINFORCING.
- ALL FIXED GLASS PANELS SHALL BE 1/2" SAFETY GLASS.
- ALL GLASS USED INSIDE DUELLING SHALL BE TEMPERED.
- CAT. II SAFETY GLASS SHALL BE USED AT ALL SHOWER AND TUB ENCLOSURES INCLUDING WINDOWS WITH SILLS LOWER THAN 60" AND MIRRORS IN THE TUB.

ITEMS	RESPONSIBILITY SCHEDULE				COMMENTS
	INTERIOR DESIGNER	MATERIALS	INSTALLATION	G.C.	
DRIVE GATES	X	X			
DECORATIVE IRON	X	X			
DECORATIVE STONE WORK ON EXTERIOR			X	X	
GARAGE DOORS			X	X	
WOOD INTERIOR DOORS-SPECIALTY	X			X	
KITCHEN CABINETRY APPLIANCES	X	X			G.C. TO COORDINATE / CABINETRY BY GULLO
SUMMER KITCHEN CABINETRY	X	X			NOT PART OF PROJECT
MILLWORK	X	X			WOOD SHELVING, CLOSETS, LINEN, ADDITIONAL CABINETRY
CABINETRY LIGHTING	X	X			UNDER CABINET LIGHTING TO BE CONFIRMED
APPLIANCES, RESIDENTIAL LAUNDRY (INTERIOR ONLY)	X			X	
COUNTERTOPS	X			X	G.C. TO FABRICATE AND CONFIRM QTY.
ENTRY DOOR	X	X			
MIRRORS - DECORATIVE BATHS	X	X			CABINET COMPANY TO CONFIRM SUPPLY SET MIRRORS
BATH TILES AND MARBLE	X			X	G.C. TO CONFIRM QUANTITIES
BATH ACCESSORIES	X			X	
FRAME-LESS SHOWER DOORS			X	X	ID. TO COORDINATE
SPECIALTY MIRROR # POWDER RM	X	X			INCLUDE DECORATIVE BEVEL
DECORATIVE BATH TILE	X			X	G.C. TO CONFIRM QTY.
POWDER ROOM VANITY	X			X	
EXIST. STONE FLOORING				X	EXIST. STONE FLOORING TO BE HONED
WOOD FLOORING	X	X			FLOORING TO BE LAID PER DESIGN / G.C. TO COORD. HEIGHTS
SPECIALTY PAINTING	X	X			FOYER FAUX FINISHING
WALL COVERING PREPARATION			X	X	REFER TO FINISH PLANS FOR OIL BASE PRIMER LOCATION
WALL PAPER	X	X			DINING RM 4 MASTER BEDROOM
STONE PAVING DRIVE COURT AND POOL	X			X	
POOL DECK	X			X	
POOL DESIGN	X			X	NOT PART OF PROJECT
POOL BUILD-OUT / EQUIPMENT			X	X	NOT PART OF PROJECT
PLUMBING FIXTURES			X	X	ID. TO PROVIDE SPECIFICATIONS
SPECIALTY LIGHTING FIXTURES	X			X	INTERIOR ONLY
MAIN HOUSE LIGHTING			X	X	
BASE AND SPECIALTY MOLDING			X	X	ID. TO PROVIDE SPECIFICATIONS
ALARM, LUTRON SYSTEM			X	X	
LANDSCAPING			X	X	NOT PART OF PROJECT
NEW STAIR DESIGN	X			X	IRON TO BE PROVIDED BY ID. / REPAIR WOOD STRINGER BY G.C.

GENERAL CONTRACTOR NOTE

- COORDINATE WORK OF THIS CONTRACT WITH OTHER CONTRACTS AND CONTRACTORS AS APPROPRIATE.
- FULLY COORDINATE WORK BETWEEN TRADES WITH ACTUAL ARCHITECTURAL, STRUCTURAL, AND SITE CONDITIONS.

RESIDENCE RENOVATION FOR
GOLDEN BEACH 555 CORP.

555 Ocean Boulevard
Golden Beach, Florida 33160

SHEET INDEX

ARCHITECTURAL (PRELIMINARY)

A-00	COVER SHEET, PROJECT NOTES
A-01	SITE PLAN
A-02	DEMOLITION PLANS
A-03	PARTIAL PROPOSED FIRST FLOOR PLAN
A-04	PARTIAL PROPOSED SECOND FLOOR PLAN
A-05	PROPOSED SECOND FLOOR PLAN
A-06	EAST AND WEST EXTERIOR ELEVATIONS
A-07	SOUTH EXTERIOR ELEVATIONS
A-08	NORTH EXTERIOR ELEVATIONS
A-09	EXTERIOR DOOR SCHEDULES AND DETAILS

ABBREVIATIONS

AFF. ABOVE FINISHED FLOOR	ID. INTERIOR DESIGNER
ADJ. ADJACENT	INSUL. INSULATION
AHF. AIR HANDLING UNIT	INT. INTERIOR
ALUM. ALUMINUM	JAN. JANITOR
AND	JOINT
AT	K.P. KICK PLATE
ALT. ALTERNATE	KIT. KITCHEN
ARCH. ARCHITECT (URAL)	LAM. LAMINATE
BM. BEAM	LAV. LAVATORY
BT. BITUMINOUS	LG. LONG
BLK. BLOCK	MAN. MANHOLE
BD. BOARD	MFR. MANUFACTURER
BOT. BOTTOM	M.O. MASONRY OPENING
BLDG. BUILDING	MAX. MAXIMUM
CAB. CABINET	MECH. MECHANICAL
CPT. CARPET	MTL. METAL
CLG. CEILING	MIN. MINIMUM
CTR. CENTER	NGVD. NATIONAL GEODETIC
CL. CENTERLINE	NORTH. NORTH AMERICAN
C.T. CERAMIC TILE	NAV.D. VERTICAL DATUM
CLEAR	N.A.V.D. NORTH
CLOS. CLOSET	N.C. NOT IN CONTRACT
COL. COLUMN	N.T.S. NOT TO SCALE
CONC. CONCRETE	NO. NO. NUMBER
CHU. CONCRETE MASONRY UNIT	OFF. OFFICE
CONT. CONTINUOUS	O.C. ON CENTER
COORD. COORDINATION	O.H. OPPOSITE HAND
CONTROL. CONTROL	OVER. OVER HANG
CORR. CORRIDOR	OPEN. OPENING
DET. DETAIL	OPNG. OPENING
DIST. DISTANCE	OHD. OVERHEAD
DR. DOOR	P. LAM. PLASTIC LAMINATE
DBL. DOUBLE	OR P. PLATE
DN. DOWN	PLY. PLYWOOD
DRAIN	REF. REFRIGERATOR
DUG. DRAIN	REIN. REINFORCED
DF. DRINKING FOUNTAIN	REQ. REQUIRED
EA. EACH	RISER
EAST	RD. ROOF DRAIN
ELEC. ELECTRICAL	RM. ROOM
EL. ELEVATION	SECT. SECTION
ELEV. ELEVATOR	SHT. SHEET
EQU. EQUIPMENT	SIM. SHOWER
EQ. EQUAL	SIM. SIMILAR
EQUIP. EQUIPMENT	SPEC. SPECIFICATION
EX. EXISTING	SQ. SQUARE
EXP. EXPOSED	STD. STANDARD
EXT. EXTERIOR	STL. STEEL
FT. FEET	THR. THRESHOLD
FIN. FINISH	UN. UNDERWRITER'S
F.A. FIRE ALARM	LAB. LABORATORIES
FE. FIRE EXTINGUISHER	TYP. UNLESS OTHERWISE NOTED
F.E.C. FIRE EXTINGUISHER CABINET	VERT. VERTICAL
FIX. FIXTURE	W.C. WATER CLOSURE
FLASH. FLASHING	W.C. WATER CLOSURE
FLOOR	W.H. WATER HEATER
F.D. FLOOR DRAIN	W.H. WATER HEATER
FLORESC. FLORESCENT	W. WOOD
FURR. FURRING	W. WOOD
GALV. GALVANIZED	W. WOOD
GA. GAUGE	W. WOOD
G.C. GENERAL CONTRACTOR	W. WOOD
GL. GLASS	W. WOOD
GB. GRAB BAR	W. WOOD
GTP. GYPSUM	W. WOOD
HDSU. HARDWARE	W. WOOD
HT. HEIGHT	W. WOOD
H.C. HOLLOW CORE	W. WOOD
HM. HOLLOW METAL	W. WOOD
HORIZ. HORIZONTAL	W. WOOD
H.B. HOSE BIBB	W. WOOD

Town of Golden Beach
Building Regulatory Advisory Board

NOV 13 2018

APPROVED
DISAPPROVED
VARIANCE REQ.

PROJECT DIRECTORY

CLIENT:	ARCHITECT:	MEP ENGINEER:
GOLDEN BEACH 555 CORP. 20801 BISCAYNE BOULEVARD AVENUE FLORIDA 33160	JAS GROUP ARCHITECTS 1855 SU 124 ST. SUITE 100 MIAMI, FLORIDA 33156	BHARMANI FORD & ASSOCIATES, INC 4800 SW 74 CT MIAMI, FLORIDA 33155
CONTACT: MARC BERNARD (917) 691-3011	JAMES SMITH AIA REG. 1007679 PHONE: (305) 596-2290 FAX: (305) 596-6422	CONTACT: TOM FORD (305) 663-1364

SUMMARY OF PROPOSED EXTERIOR MODIFICATIONS

THIS PROJECT CONSISTS OF NECESSARY LABOR, MATERIAL, EQUIPMENT AND SERVICES REQUIRED TO CONSTRUCT EXTERIOR IMPROVEMENTS INCLUDING CONSTRUCTION OF NEW ELEVATOR (NO AREA ADDED TO BUILDING FOOTPRINT), ADDITION OF NEW EXTERIOR STONE DECORATIONS TO EXISTING WALLS, PAINTING OF EXTERIOR WALLS, REPLACEMENT OF ROOF TILES, REPLACEMENT OF EXISTING PAVEMENT, POOL DECK, REPLACEMENT OF EXISTING STONE IN SAME LOCATIONS, RELOCATION OF POOL EQUIPMENT & HEATER, REPLACEMENT OF EXTERIOR DOORS, SIZE-FOR-SIZE IN EXISTING OPENINGS, REPLACEMENT OF EXISTING BALCONY AND STAIR RAILS AND ADDITION OF NEW DECORATIVE IRON OR BRONZE RAILS AND GRILLES.

NO INCREASE IN BUILDING FOOTPRINT OR LOT COVERAGE IS PROPOSED. NO INCREASE IN IMPERVIOUS AREA IS PROPOSED. EXISTING PAVEMENT, DRIVEWAYS, AND POOL DECK ARE TO BE REPLACED WITH NEW STONE PAVING IN SAME LAYOUT. NO MODIFICATION TO EXISTING LANDSCAPING OR DRAINAGE IS PROPOSED.

EXISTING CONDITIONS

REMOVE ALL ABANDONED MATERIALS, DEVICES, FIXTURES, PIPES, CONDUITS, WIRES, ETC. FROM PREMISES. IF REQUIRED, CONTRACTOR TO PATCH, REPAIR AND/OR REPLACE EXISTING CEILINGS, WALLS, FLOORING, LIGHTING, ETC. INDICATED TO REMAIN OR BE RE-USED.

IN THE EVENT OWNER'S CONTRACTOR ENCOUNTERS UNIDENTIFIED ASBESTOS CONTAINING MATERIALS (ACM) THE OWNER MUST BE CONTACTED IMMEDIATELY FOR DIRECTION. AT NO TIME WILL THESE ACM BE REMOVED OR EVEN DISTURBED, BY OTHER THAN AN ASBESTOS CONTRACTOR LICENSED TO DO SUCH WORK AND IN ACCORDANCE WITH GOVERNING REGULATIONS AND GUIDELINES.

RESIDENTIAL RENOVATION NOTE

NOTE TO OWNER AND GENERAL CONTRACTOR: DURING THE COURSE OF WORK OUTLINED WITHIN THESE CONSTRUCTION DOCUMENTS FOR THIS REMODELING, UNEXPECTED CONSTRUCTION FIELD CONDITIONS MAY ARISE. SUCH CONDITIONS SHALL BE ADDRESSED AND RESOLVED IN THE FIELD BY THE CONTRACTOR AND ARCHITECT, AND REVIEWED WITH THE OWNER PRIOR TO PROCEEDING. UNFORESEEN CONDITIONS MAY ARISE BASED UPON EXISTING NOT READILY VISIBLE ("CONCEALED CONDITIONS") PRIOR TO CONSTRUCTION COMMENCEMENT, AND THEREFORE WERE NOT REFLECTED AS PART OF THIS SCOPE OF WORK.

OWNER MAINTENANCE NOTE

GENERAL CONTRACTOR IS TO INFORM THE OWNER THAT IT IS THE SOLE RESPONSIBILITY OF THE OWNER TO MAINTAIN THE RESIDENCE, AND THAT MAINTENANCE IS REQUIRED TO ENSURE THE ARCHITECTURAL, STRUCTURAL, MECHANICAL, PLUMBING AND ELECTRICAL INTEGRITY OF THE RESIDENCE.

CLASSIFICATION OF WORK

GENERAL CONTRACTOR NOTE: ALTERATIONS (LEVEL 2)

LEVEL 2 ALTERATIONS INCLUDE THE RECONFIGURATION OF SPACE, THE ADDITION OR ELIMINATION OF ANY DOOR OR WINDOW, THE RECONFIGURATION OF EXTENSION OF ANY SYSTEM, OR THE ILLUSTRATION OF ANY ADDITIONAL EQUIPMENT.

PROVIDED ON PLAN

EXISTING N/A


☐ SMOKE DETECTORS	☐ SMOKE DETECTORS
☐ BEDROOM-SECOND MEANS OF EGRESS	☐ BEDROOM-SECOND MEANS OF EGRESS
☐ GFCI OUTLETS WHERE REQUIRED	☐ GFCI OUTLETS WHERE REQUIRED
☐ IMPACT RESISTANCE DEVICES ON EXTERIOR OPENINGS	☐ IMPACT RESISTANCE DEVICES ON EXTERIOR OPENINGS

THIS CERTIFIES THAT JAS GROUP HAS VISITED THE SITE AND TO THE BEST OF OUR KNOWLEDGE AND BELIEF HAVE DETERMINED THAT THE ABOVE INDICATED REMEDIAL ACTIONS ARE TO BE PERFORMED AS PART OF THE OVERALL IMPROVEMENT PLAN.

APPLICABLE CODES

- FLORIDA BUILDING CODE - FIFTH EDITION (FBC 2014) RESIDENTIAL
- FLORIDA BUILDING CODE - FIFTH EDITION (FBC 2014) EXISTING BUILDING
- FLORIDA BUILDING CODE - FIFTH EDITION (FBC 2014) MECHANICAL
- FLORIDA BUILDING CODE - FIFTH EDITION (FBC 2014) PLUMBING
- FLORIDA BUILDING CODE - FIFTH EDITION (FBC 2014) FUEL GAS
- FLORIDA BUILDING CODE - FIFTH EDITION (FBC 2014) ENERGY CONSERVATION
- FLORIDA BUILDING CODE - FIFTH EDITION (FBC 2014) TEST PROTOCOLS
- FLORIDA FIRE PREVENTION CODE, FIFTH EDITION
- (NFPA) & NFPA 101-LIFESAFETY CODE (2012)
- TOWN OF GOLDEN BEACH CODE OF ORDINANCES
- REGULATIONS OF LOCAL AUTHORITIES HAVING JURISDICTION
- NATIONAL ELECTRICAL CODE - LATEST ISSUE
- OSHA REGULATIONS
- FEMA REGULATIONS

EXECUTE ALL WORK IN ACCORDANCE WITH LOCAL AND FEDERAL CODES, MANUFACTURER'S RECOMMENDATIONS, TRADE AND REFERENCE STANDARDS, INCLUDING BUT NOT LIMITED TO NFPA, ASME, UNIC, AND AMERICAN WITH DISABILITIES ACT, LATEST EDITIONS.

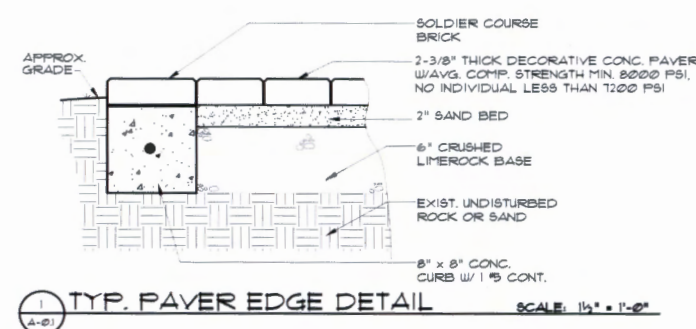

1. CONTRACTOR SHALL VERIFY ALL DIMENSIONS AND CONDITIONS AT THE JOB SITE AND SHALL NOTIFY ARCHITECT OF ANY DISCREPANCIES OR ERRORS BEFORE PROCEEDING WITH THE WORK.
2. ALL MATERIALS AND WORK SHALL CONFORM TO ALL GOVERNING AGENCIES AND APPLICABLE CODES.
3. SPECIFIC DETAILS AND NOTES SHALL TAKE PRECEDENCE OVER GENERAL NOTES AND CONDITIONS. ALL ACCESS PANELS AS REQUIRED, LOCATION AND TYPE SHALL BE APPROVED BY ARCHITECT PRIOR TO OBTAINING AND INSTALLING.
4. CONTRACTOR SHALL PROVIDE A PORTABLE FIRE EXTINGUISHER WITH A RATING OF NOT LESS THAN 4A 60 B C FOR PROTECTION DURING CONSTRUCTION.
5. CONTRACTOR SHALL BE RESPONSIBLE FOR VERIFICATION AND CORRECTION OF SUBCONTRACTOR'S WORK TO SECURE COMPLIANCE OF DRAWINGS AND SPECIFICATIONS, THE ACCURATE LOCATION OF STRUCTURAL MEMBERS, AND OPENINGS FOR MECHANICAL, ELECTRICAL, AND MISCELLANEOUS EQUIPMENT.
6. SUBMIT SHOP DRAWINGS AND CATALOGS OF EQUIPMENT AS REQUIRED.
7. CONTRACTOR SHALL VERIFY SIZES AND LOCATIONS OF ALL OPENINGS FOR MECHANICAL EQUIPMENT WITH MECHANICAL CONTRACTOR BEFORE PROCEEDING WITH THE WORK.
8. DOORS NOT LOCATED BY DIMENSIONS SHALL BE CENTERED IN WALL OR SHALL BE LOCATED FIVE INCHES FROM FINISH WALL TO EDGE OF DOOR BUCK.
9. ALL TRADES SHALL, AT ALL TIMES, KEEP THE PREMISES FREE FROM ACCUMULATION OF WASTE MATERIALS OR RUBBISH CAUSED BY THEIR WORK.
10. CONTRACTOR SHALL COMPARE CAREFULLY THE LINES AND LEVELS SHOWN ON DRAWINGS WITH EXISTING LEVELS FOR THE LOCATION AND CONSTRUCTION OF ALL WORK. CONTRACTOR SHALL BE GIVEN ATTENTION TO ANY DISCREPANCIES BEFORE PROCEEDING WITH THE WORK.
11. CONTRACTOR SHALL FURNISH AND MAINTAIN TEMPORARY SANITATION FACILITIES AS REQUIRED DURING CONSTRUCTION. BRACING AND TEMPORARY SUPPORTS SHALL BE PROVIDED AS REQUIRED TO HOLD THE WORK SECURELY IN PLACE, AND TO SUSTAIN ALL LOADS THAT MAY OCCUR DURING ERECTION AND UNTIL SUBSEQUENT CONSTRUCTION IS ADEQUATE TO REPLACE.
12. CONTRACTOR SHALL PROVIDE AND INSTALL ALL STIFFENERS, BRACING, BACK-UP PLATES AND SUPPORTING BRACKETS REQUIRED FOR INSTALLATION OF ALL CASEWORK AND OF ALL WALL MOUNTED OR SUSPENDED MECHANICAL, ELECTRICAL OR MISCELLANEOUS EQUIPMENTS.

PRIOR TO REMOVAL OF ANY SUPPORT MEMBERS, PROVIDE INTERIOR AND EXTERIOR SHORING, BRACING, OR SUPPORT TO PREVENT MOVEMENT OR COLLAPSE OF STRUCTURES TO BE DEMOLISHED AND ADJACENT FACILITIES TO REMAIN.

1. EVERY DOOR WINDOW SHALL BE SECURED AND PROTECTED AGAINST FORCED ENTRY AS REQUIRED IN METRO-DADE CODE.
2. EXTERIOR DOORS SERVING AS PRIMARY MEANS OF EGRESS SHALL BE EQUIPPED WITH A COMBINATION DEAD LATCH AND DEAD BOLT DEVICE.
3. SLIDING GLASS DOORS IN EXTERIOR WALLS AND ACCESSIBLE FROM OUTSIDE SHALL BE PROVIDED WITH SLIDING DOOR DEAD BOLTS, OR A BOLT OR A PIN NOT REMOVABLE OR OPERABLE FROM THE EXTERIOR, AT THE JAMB, HEAD, SILL, OR AT THE MEETING MULLIONS.
4. LOOKS ON EXTERIOR WINDOWS SHALL COMPLY WITH F.B.C.
5. WOOD JAMBS SHALL BE SECURED AT A MINIMUM OF 6 POINTS OF ANCHORING FOR VERTICAL SIDE.
6. SUB-BUCKS SHALL BE OF PRESSURED MATERIAL WITH NOMINAL THICKNESS TO CORRESPOND WITH PRODUCT APPROVAL NOA, AND SECURED AT NOA SPECIFIED POINTS ON EACH LEG WITH FASTENERS PER PRODUCT APPROVAL NOA.
7. SLIDING DOORS SHALL BE CONSTRUCTED AND INSTALLED SO THAT NO PANEL CAN BE LIFTED FROM THE TRACKS WHEN IN A LOCKED POSITION AND PROVIDED WITH LOOKS AS SET FORTH IN THE F.B.C.
8. VENTS IN OVERHEAD TYPE GARAGE DOORS SHALL NOT EXCEED 8" IN LEAST DIMENSION, AND SHALL NOT BE LOCATED 40" FROM THE INSIDE LOCK-ACTIVATION DEVICE.
9. EXTERIOR WINDOWS SHALL BE LOCKED WITH AN INSIDE DEVICE CAPABLE OF WITHSTANDING A FORCE OF 150 LBS. APPLIED IN ANY OPERABLE DIRECTION, UNLESS THE WINDOW OPENING IS PROTECTED BY OTHER SECURITY AND APPROVED EXTENSION PREVENTION DEVICES AS SET FORTH HEREIN, OR AN EQUIVALENT.
10. ALL EXTERIOR WINDOWS SHALL BE CONSTRUCTED SO THAT WHERE FIXED OR LOOKED THEY CANNOT BE REMOVED FROM THE FRAMES FROM OUTSIDE UNLESS THE WINDOW OPENING IS PROTECTED.
11. SLIDING EXTERIOR DOORS & DOORS CONNECTING GARAGE AREAS SHALL COMPLY WITH F.B.C. AND SHALL BE SECURED WITH A LATCH AND A SINGLE DEAD BOLT WITH 1" MINIMUM THROW, OR A COMBINATION OF DEAD LATCH AND DEAD BOLT SET.
12. MAIN ENTRANCE DOOR SHALL BE PROVIDED WITH A DOOR SCOPE OR VISION PANELS COMPLYING THE F.B.C.

	CMU		PLASTER/GYPSUM BLOCK STUCCO/PRECAST
	CONCRETE		WOOD BLOCKING
	STEEL		PLYWOOD
	BATT INSULATION		RIGID INSULATION
	EARTH		FINISH WOOD

BUILDING SECTION SYMBOL

- SECTION IDENTIFICATION
- DIRECTION WHERE SECTION IS VIEWED
- DRAWING WHERE SECTION IS SHOWN

LOCATION OF ELEVATION

ELEVATION IDENTIFICATION


ROOM NAME
ROOM NUMBER

PARTITION IDENTIFICATION

WINDOW IDENTIFICATION


DOOR IDENTIFICATION

1. INSTALL NEW TRANSFER SWITCH FOR FUTURE GENERATOR. (SEE ELECT. PLANS)
2. REMOVE & REPLACE EXIST. ELECT. METER, DISC., & EQUIPMENT. RECONNECT TO EXIST. SERVICE.
3. REMOVE & REPLACE EXIST. PAVERS DRIVE, WALK, & POOL DECK W/ NEW "JERUSALEM STONE PAVERS" (BY OTHERS) (SEE TYP. PAVERS DETAIL).
4. PROVIDE NEW "JERUSALEM STONE SLAB" FINISH STEPS, & LANDING. # ENTRY, & COVERED TERRACE.
5. PROVIDE NEW TIERED LANDSCAPE BEDS (BY OTHERS) # EXIST. FLORIDA EA. SIDE OF STEPS # ENTRY. (SEE ELECT. & PLUMBING PLANS)
6. PATCH, REPAIR, & CLEAN EXIST. CBS BULKHEAD WALL AS NEEDED IN PREPARATION FOR NEW PAINT FINISH.
7. SEE ID. DUGS. FOR ENTRY COLUMNS, & CBS LANDSCAPE WALL FINISHES.
8. REMOVE & REPLACE ENTRY GATE 9/12 FOR 9/12 IN EXIST. OPENING. GATE CONFIGURATION TO MATCH EXIST. ACCESS SYSTEM, & HARDWARE ALSO TO BE REPLACED. (BY OTHERS)
9. REMOVE & REPLACE POOL COPING (BY OTHERS)
10. NOT USED

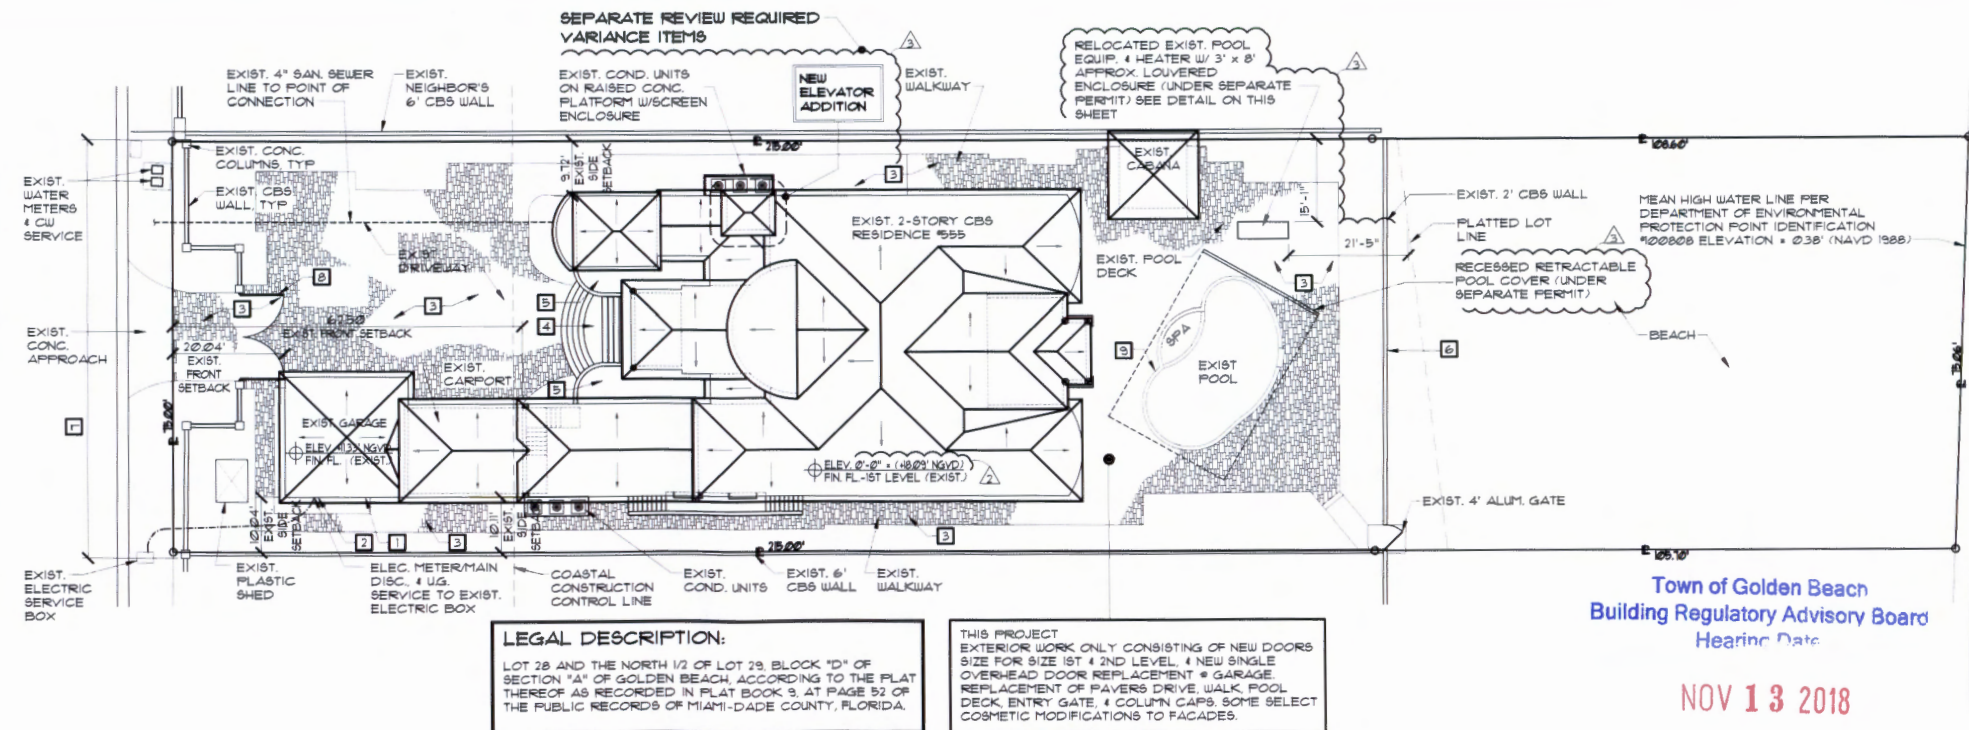

SCALE: 1/16" = 1'-0"

APPROVED _____
DISAPPROVED _____
VARIANCE REQ. _____

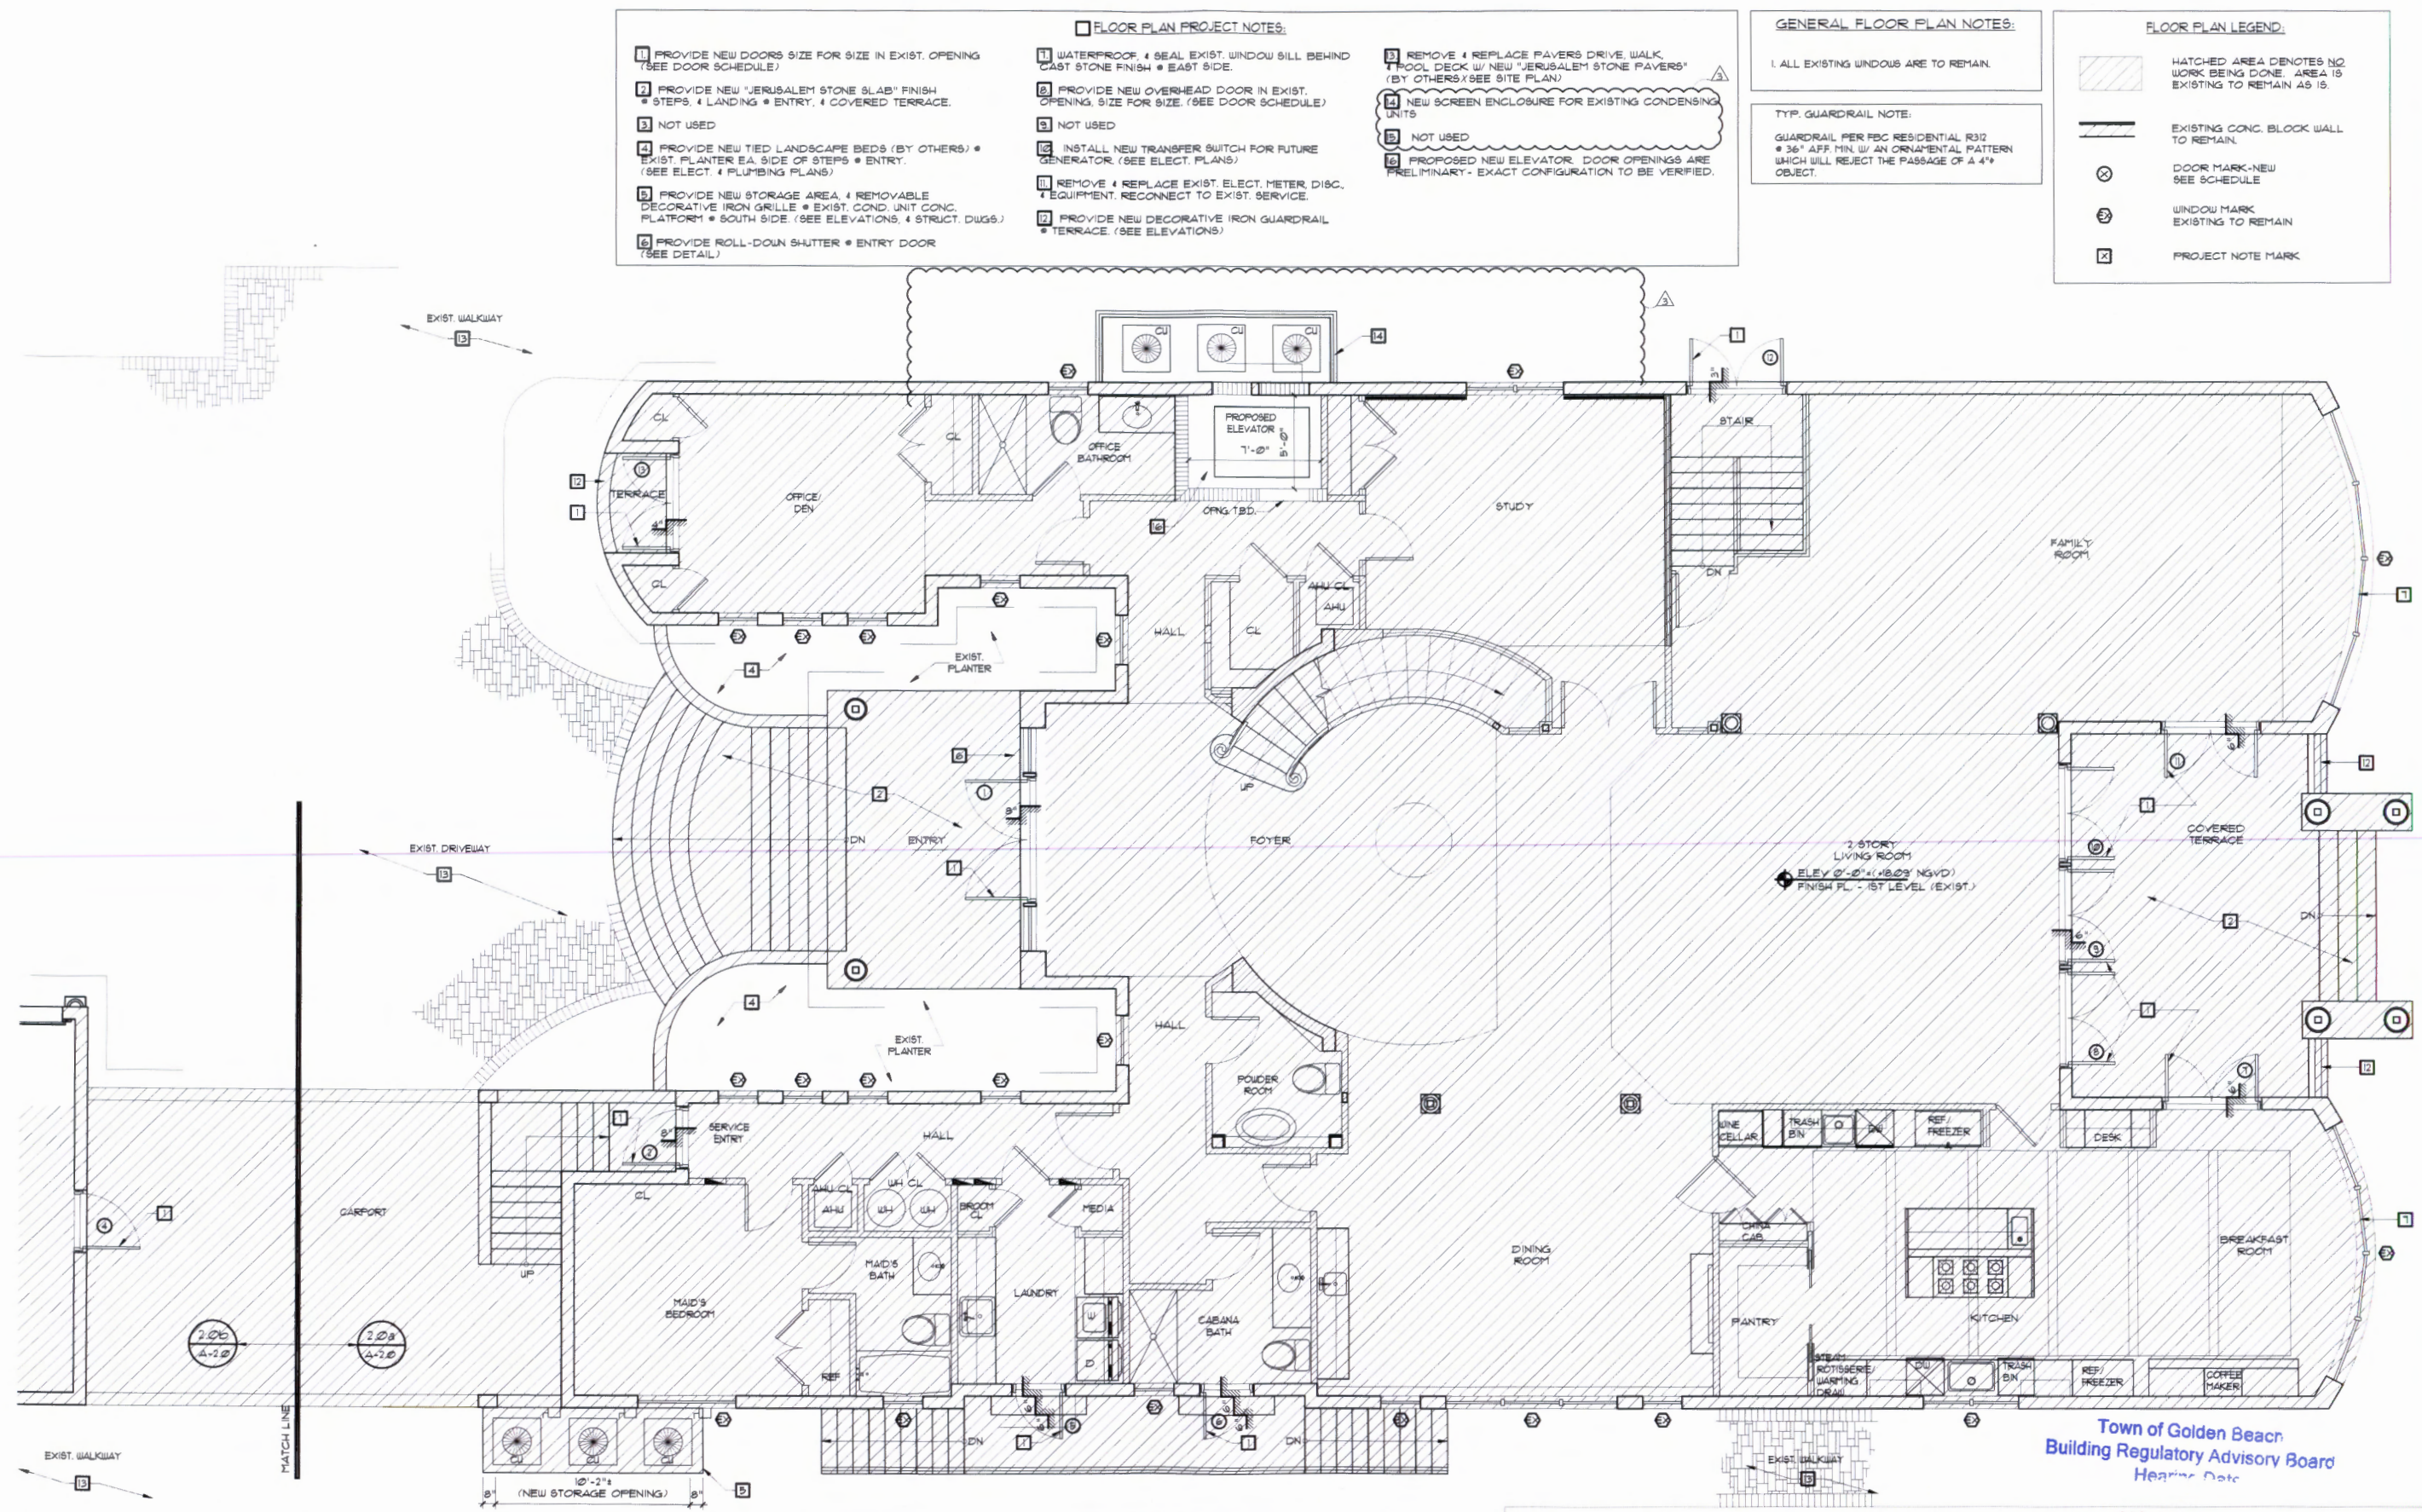

- FLOOR PLAN PROJECT NOTES:**
- 1. PROVIDE NEW DOORS SIZE FOR SIZE IN EXIST. OPENING (SEE DOOR SCHEDULE)
 - 2. PROVIDE NEW "JERUSALEM STONE SLAB" FINISH • STEPS, • LANDING • ENTRY, • COVERED TERRACE.
 - 3. NOT USED
 - 4. PROVIDE NEW TIED LANDSCAPE BEDS (BY OTHERS) • EXIST. PLANTER EA. SIDE OF STEPS • ENTRY. (SEE ELEC. & PLUMBING PLANS)
 - 5. PROVIDE NEW STORAGE AREA, • REMOVABLE DECORATIVE IRON GRILLE • EXIST. COND. UNIT CONC. PLATFORM • SOUTH SIDE. (SEE ELEVATIONS, • STRUCT. DWGS.)
 - 6. PROVIDE ROLL-DOWN SHUTTER • ENTRY DOOR (SEE DETAIL)
 - 7. WATERPROOF, • SEAL EXIST. WINDOW SILL BEHIND CAST STONE FINISH • EAST SIDE.
 - 8. PROVIDE NEW OVERHEAD DOOR IN EXIST. OPENING, SIZE FOR SIZE. (SEE DOOR SCHEDULE)
 - 9. NOT USED
 - 10. INSTALL NEW TRANSFER SWITCH FOR FUTURE GENERATOR. (SEE ELEC. PLANS)
 - 11. REMOVE • REPLACE EXIST. ELECT. METER DISC, • EQUIPMENT, RECONNECT TO EXIST. SERVICE.
 - 12. PROVIDE NEW DECORATIVE IRON GUARDRAIL • TERRACE. (SEE ELEVATIONS)
 - 13. REMOVE • REPLACE PAVERS DRIVE WALK, • POOL DECK W/ NEW "JERUSALEM STONE PAVERS" (BY OTHERS) SEE SITE PLAN)
 - 14. NEW SCREEN ENCLOSURE FOR EXISTING CONDENSING UNITS
 - 15. NOT USED
 - 16. PROPOSED NEW ELEVATOR. DOOR OPENINGS ARE PRELIMINARY - EXACT CONFIGURATION TO BE VERIFIED.

GENERAL FLOOR PLAN NOTES:

1. ALL EXISTING WINDOWS ARE TO REMAIN.

TYP. GUARDRAIL NOTE:

GUARDRAIL PER FBC RESIDENTIAL R312 • 36" AFF. MIN. W/ AN ORNAMENTAL PATTERN WHICH WILL REJECT THE PASSAGE OF A 4" OBJECT.

- FLOOR PLAN LEGEND:**
- HATCHED AREA DENOTES NO WORK BEING DONE. AREA IS EXISTING TO REMAIN AS IS.
 - EXISTING CONC. BLOCK WALL TO REMAIN.
 - DOOR MARK-NEW SEE SCHEDULE
 - WINDOW MARK EXISTING TO REMAIN
 - PROJECT NOTE MARK

FIRST FLOOR PLAN

SCALE: 1/4"=1'-0"



Town of Golden Beach
Building Regulatory Advisory Board
Hearing Date

NOV 13 2018

APPROVED
DISAPPROVED
VARIANCE



APPROVED _____
DISAPPROVED _____
VARIANCE REQ. _____


NOV 13 2018

1. PROVIDE NEW DOORS SIZE FOR SIZE IN EXIST. OPENING (SEE DOOR SCHEDULE).
2. PROVIDE NEW DECORATIVE IRON GUARDRAIL & BALCONIES. (SEE ELEVATIONS)
3. PROPOSED NEW ELEVATOR. DOOR OPENINGS ARE PRELIMINARY - EXACT CONFIGURATION TO BE VERIFIED.
4. NEW CBS CONSTRUCTION ELEVATOR SHAFT.
5. REPLACE EXISTING VANITY CABINET WITH SMALLER CABINET.

1. ALL EXISTING WINDOWS ARE TO REMAIN.

1. ALL EXISTING WINDOWS ARE TO REMAIN.

	HATCHED AREA DENOTES NO WORK BEING DONE. AREA IS EXISTING TO REMAIN AS IS.
	EXISTING CONC. BLOCK WALL TO REMAIN.
	DOOR MARK-NEW SEE SCHEDULE
	WINDOW MARK EXISTING TO REMAIN
	PROJECT NOTE MARK

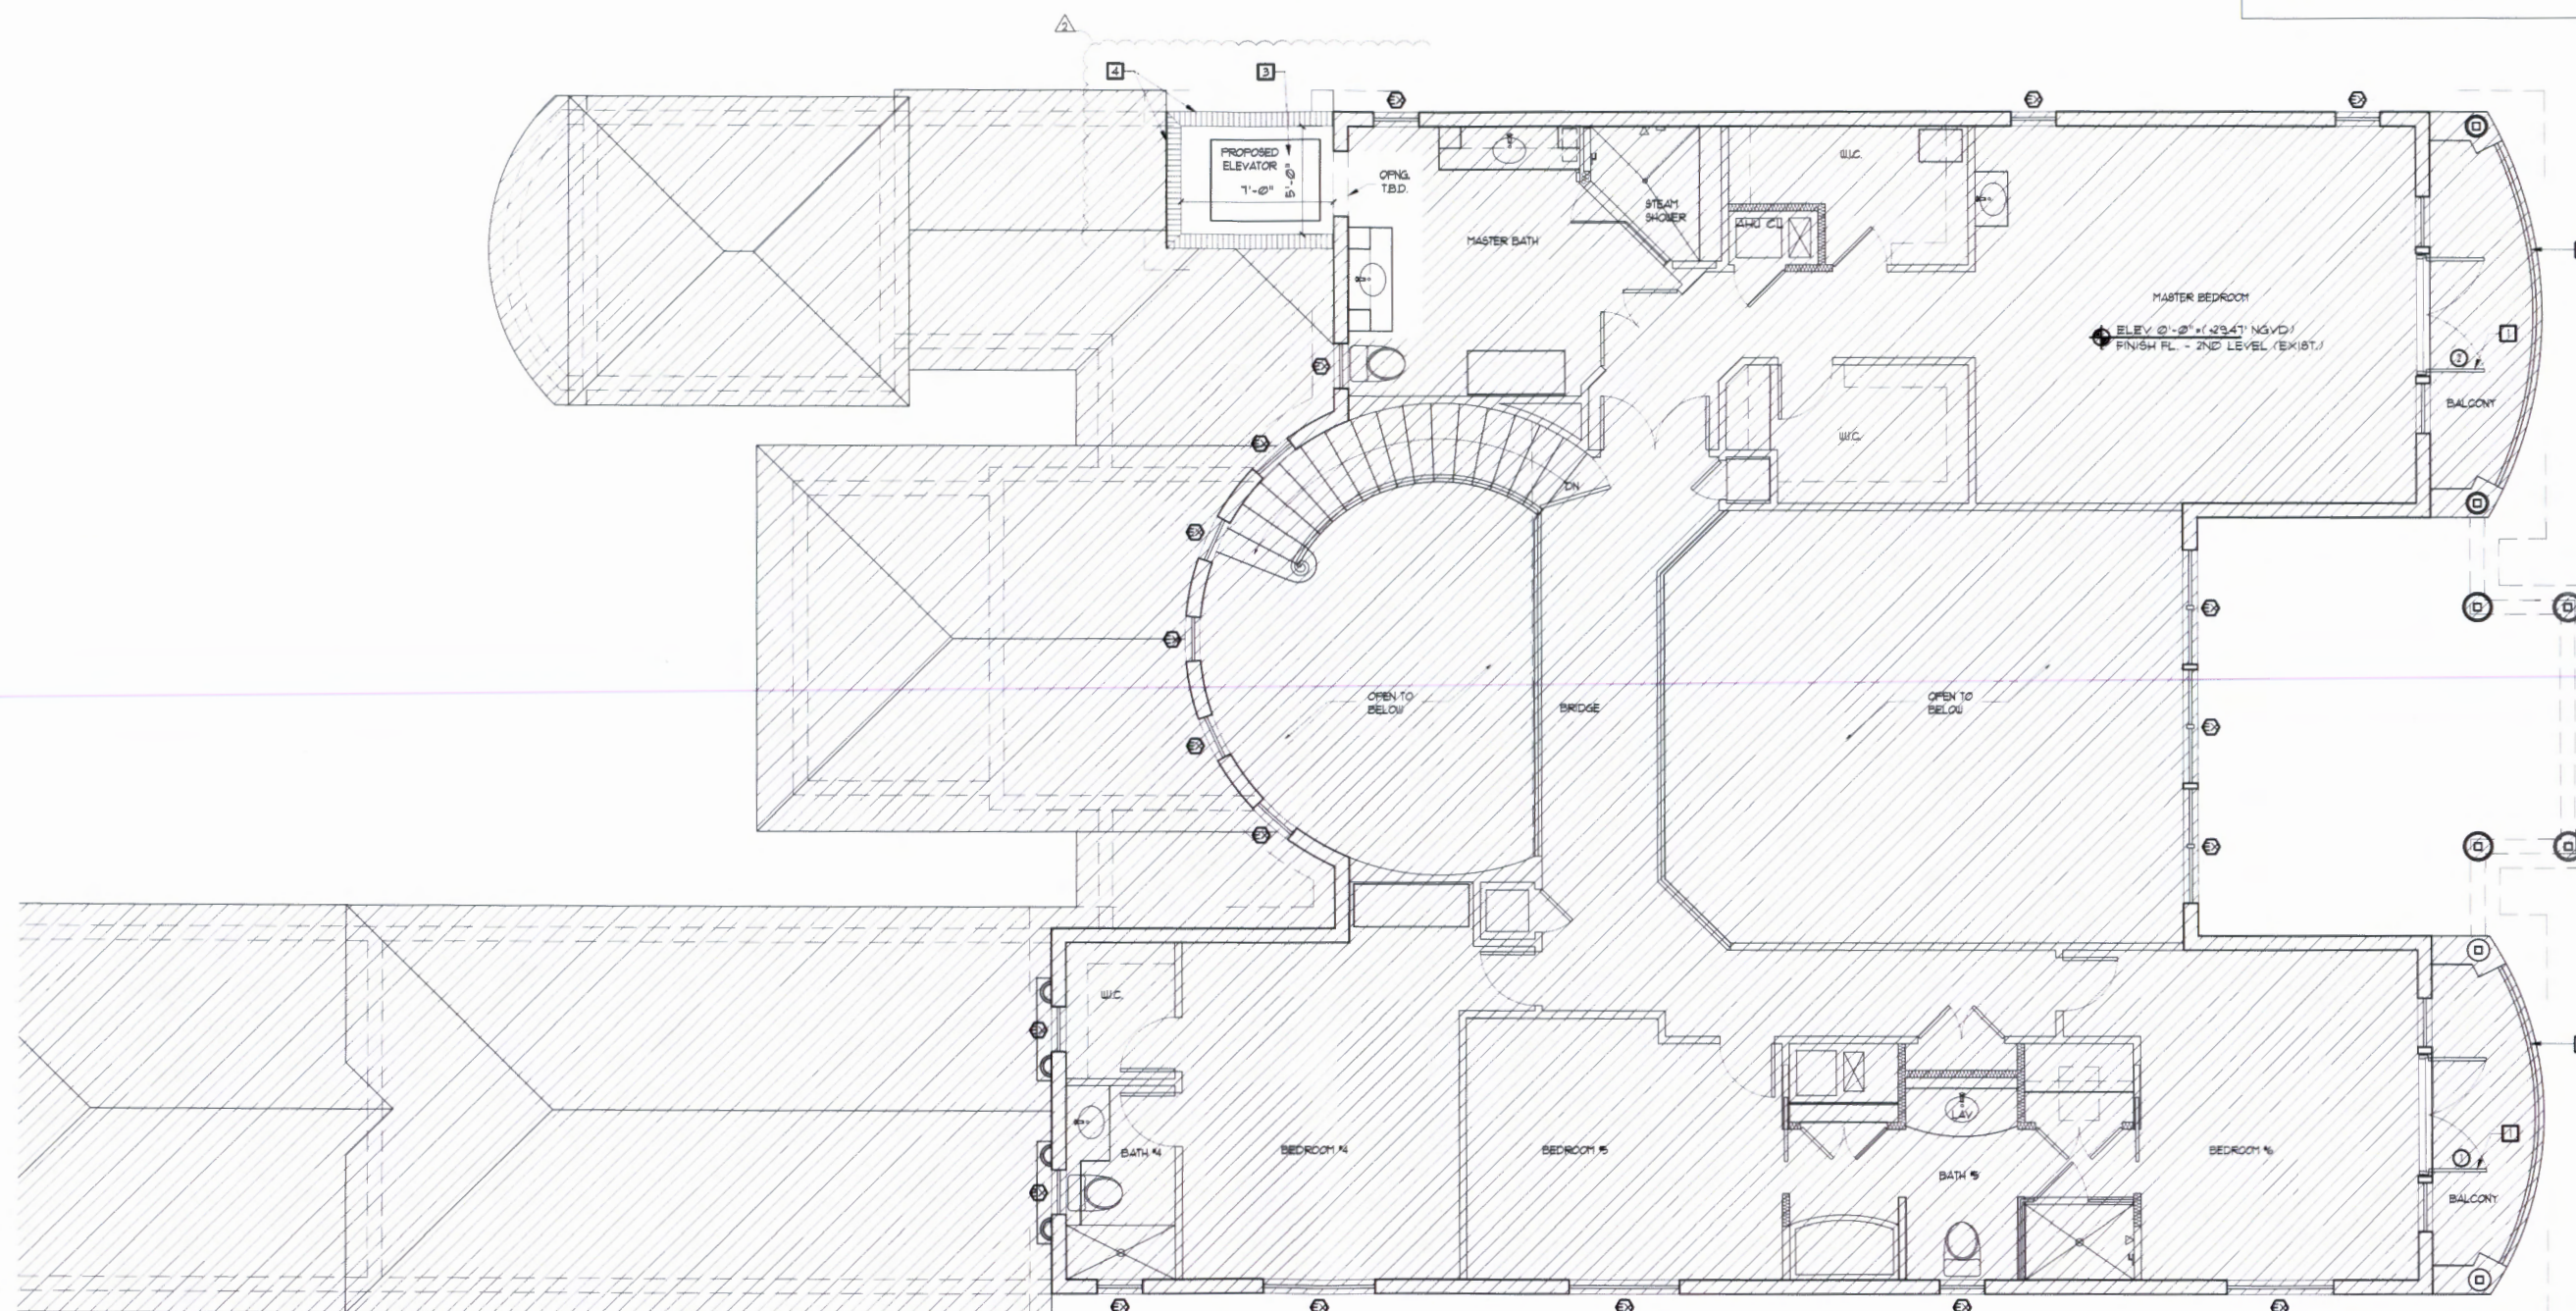


SCALE: 1/4"=1'-0"



Town of Golden Beach
Building Regulatory Advisory Board


NOV 13 2003

APPR
DISAP
VARIANCE

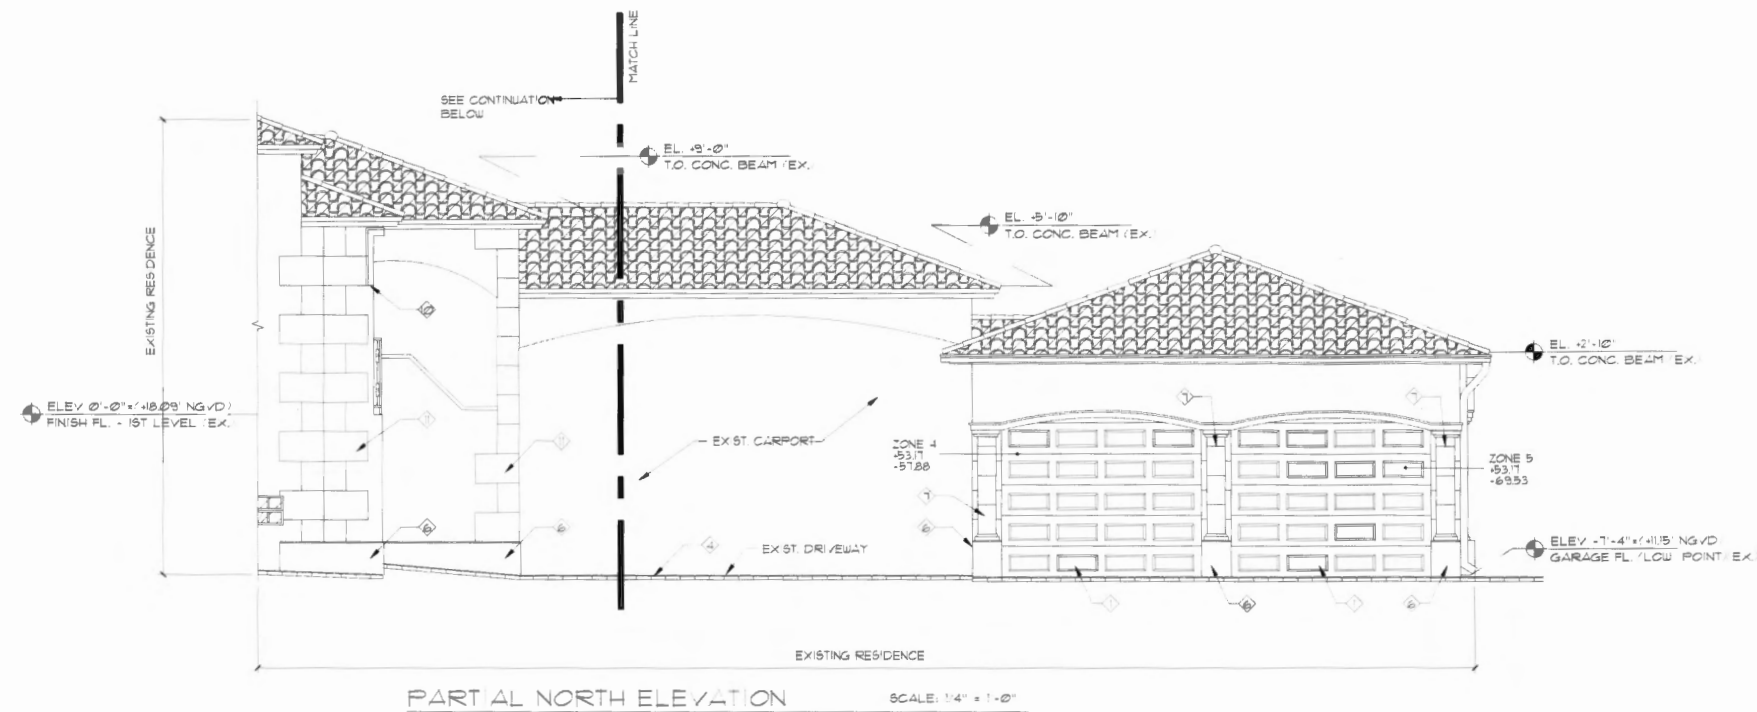

- GENERAL ELEVATION NOTES:**
1. ALL EXISTING WINDOWS ARE TO REMAIN.
 2. REMOVE, REPLACE OR RESTORE EXIST. CAST STONE TRIM AS NEEDED. SEE ID. DUGS. MATCH EXIST. PROFILE, COLOR & TEXTURE. SEE EXTERIOR FINISH NOTE.
 3. PROVIDE NEW PAINT FINISH TO ENTIRE RESIDENCE INCLUDING CABANA ENTRY COLUMNS & LANDSCAPE WALLS. SEE EXTERIOR FINISH NOTE.
 4. REMOVE & REPLACE ALL EXIST. GUTTERS & DOWNSPOUTS w/ COPPER MATERIAL.
 5. ALL SURFACE MOUNTED ELECT. CONDUIT CABLES ETC. TO BE CONCEALED IN BLOCK WALLS.
- ELEVATION KEY LEGEND**
1. NEW DOOR SIZE FOR SIZE IN EXIST. OPENING. (SEE DOOR SCHEDULE.)
 2. NEW DECORATIVE IRON GUARDRAIL @ BALCONY'S (SUBMIT SHOP DUGS. FOR ARCHITECT REVIEW & APPROVAL.)
 3. WATERPROOF & SEAL EXIST. WINDOW SILL.
 4. REMOVE & REPLACE PAVERS DRIVE WALK & POOL DECK w/ NEW JERUSALEM STONE PAVERS (BY OTHERS/SEE SITE PLAN.)
 5. MOVE CONDENSATE DRAIN PIPE AWAY FROM BUILDING STRUCTURE.
 6. PRECAST STONE BASE SEE ID. DUGS.
 7. MARBLE TILE SEE ID. DUGS.
 8. NEW COLUMN WRAP SEE ID. DUGS.
 9. WINDOW CASE MOLDING SEE ID. DUGS.
 10. DECO CORBEL BRACKET SEE ID. DUGS.
 11. MARBLE PAVERS SEE ID. DUGS.
 12. OFFSET EXISTING DOWNSPOUT TO DRAIN AT WEST SIDE OF EQUIPMENT AS SHOWN.
 13. ADDITION-PROPOSED ELEVATOR SHAFT. NEW CBS WALLS WITH PAINT-STUCCO TO MATCH EXISTING WALLS.
 14. EXISTING WINDOW TO BE REMOVED AND INFILLED WITH CBS CONSTRUCTION. PAINT-STUCCO TO MATCH EXISTING WALLS.
 15. PROVIDE NEW DECORATIVE IRON GUARDRAIL AND HANDRAIL @ NEW RAMP & LANDING @ ELEVATOR DOOR (SUBMIT SHOP DUGS. FOR ARCHITECT REVIEW & APPROVAL.)
 16. NOT USED
 17. NOT USED
 18. NOT USED

- ELEVATION LEGEND:**
- HATCHED AREA DENOTES NO WORK BEING DONE. AREA IS EXISTING TO REMAIN AS IS.
- ELEVATION KEY MARK**
- ELEVATION NOTES:**
- FOR ALL DOOR SIZES REFER TO DOOR SCHEDULE.
- EXTERIOR FINISH NOTES:**
1. ALL NEW OR EXIST. STUCCO FINISH SHALL BE PRIMED & FINISHED w/ 2 COATS OF HIGH QUALITY EXTERIOR GRADE LATEX PAINT IN COLORS & FINISHES AS OWNER SELECTS.
 2. ALL DRIP EDGES w/ FASCIA & TRIM BOARDS SHALL BE PRIMED & FINISHED w/ 2 COATS OF HIGH QUALITY EXTERIOR OIL BASE PAINT IN COLORS & FINISH AS OWNER SELECTS.
 3. ALL PRECAST ARCHITECTURAL STONE ELEMENTS ARE APPLIED TO MASONRY OR CONCRETE. USE MIN. 1/4" x 1/2" INBED "TAPCON" AT 12" O.C. COUNTERSINK IN PRECAST. PATCH AND FINISH WITH MANUFACTURER'S APPROVED COLOR-MATCHED GROUT.
- STUCCO NOTE:**
- ANY EXIST. EXTERIOR WALLS w/ DAMAGED AREAS DUE TO CONSTRUCTION SHALL RECEIVE NEW MIN. 5/8" THICK SMOOTH STUCCO FINISH TO MATCH EXIST. CONTRACTOR SHALL PRESSURE CLEAN & APPLY A BONDING AGENT TO ALL EXIST. SURFACES TO RECEIVE NEW STUCCO PRIOR TO APPLICATION.

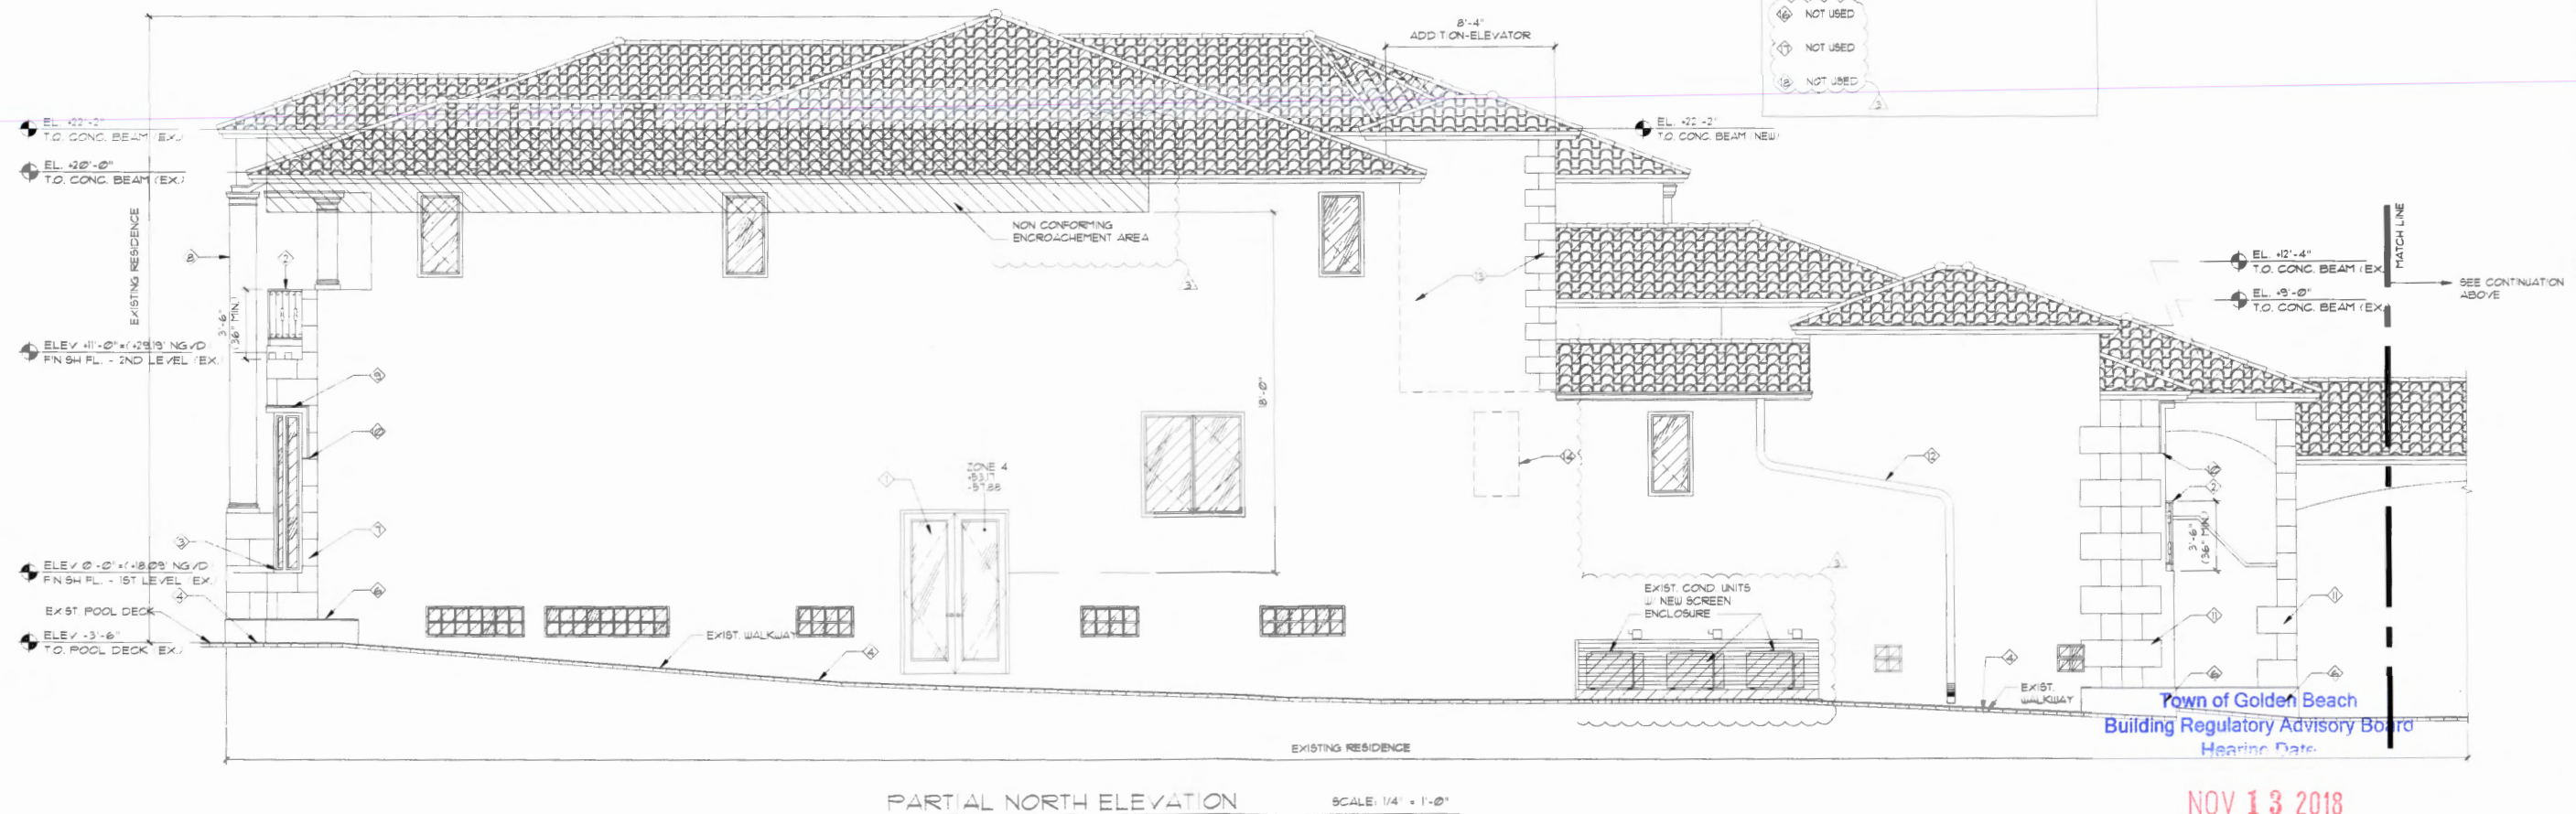

APPROVED _____
DISAPPROVED _____
VARIANCE REQ. _____

NOV 13 2018